




BACK GARDEN PLAN

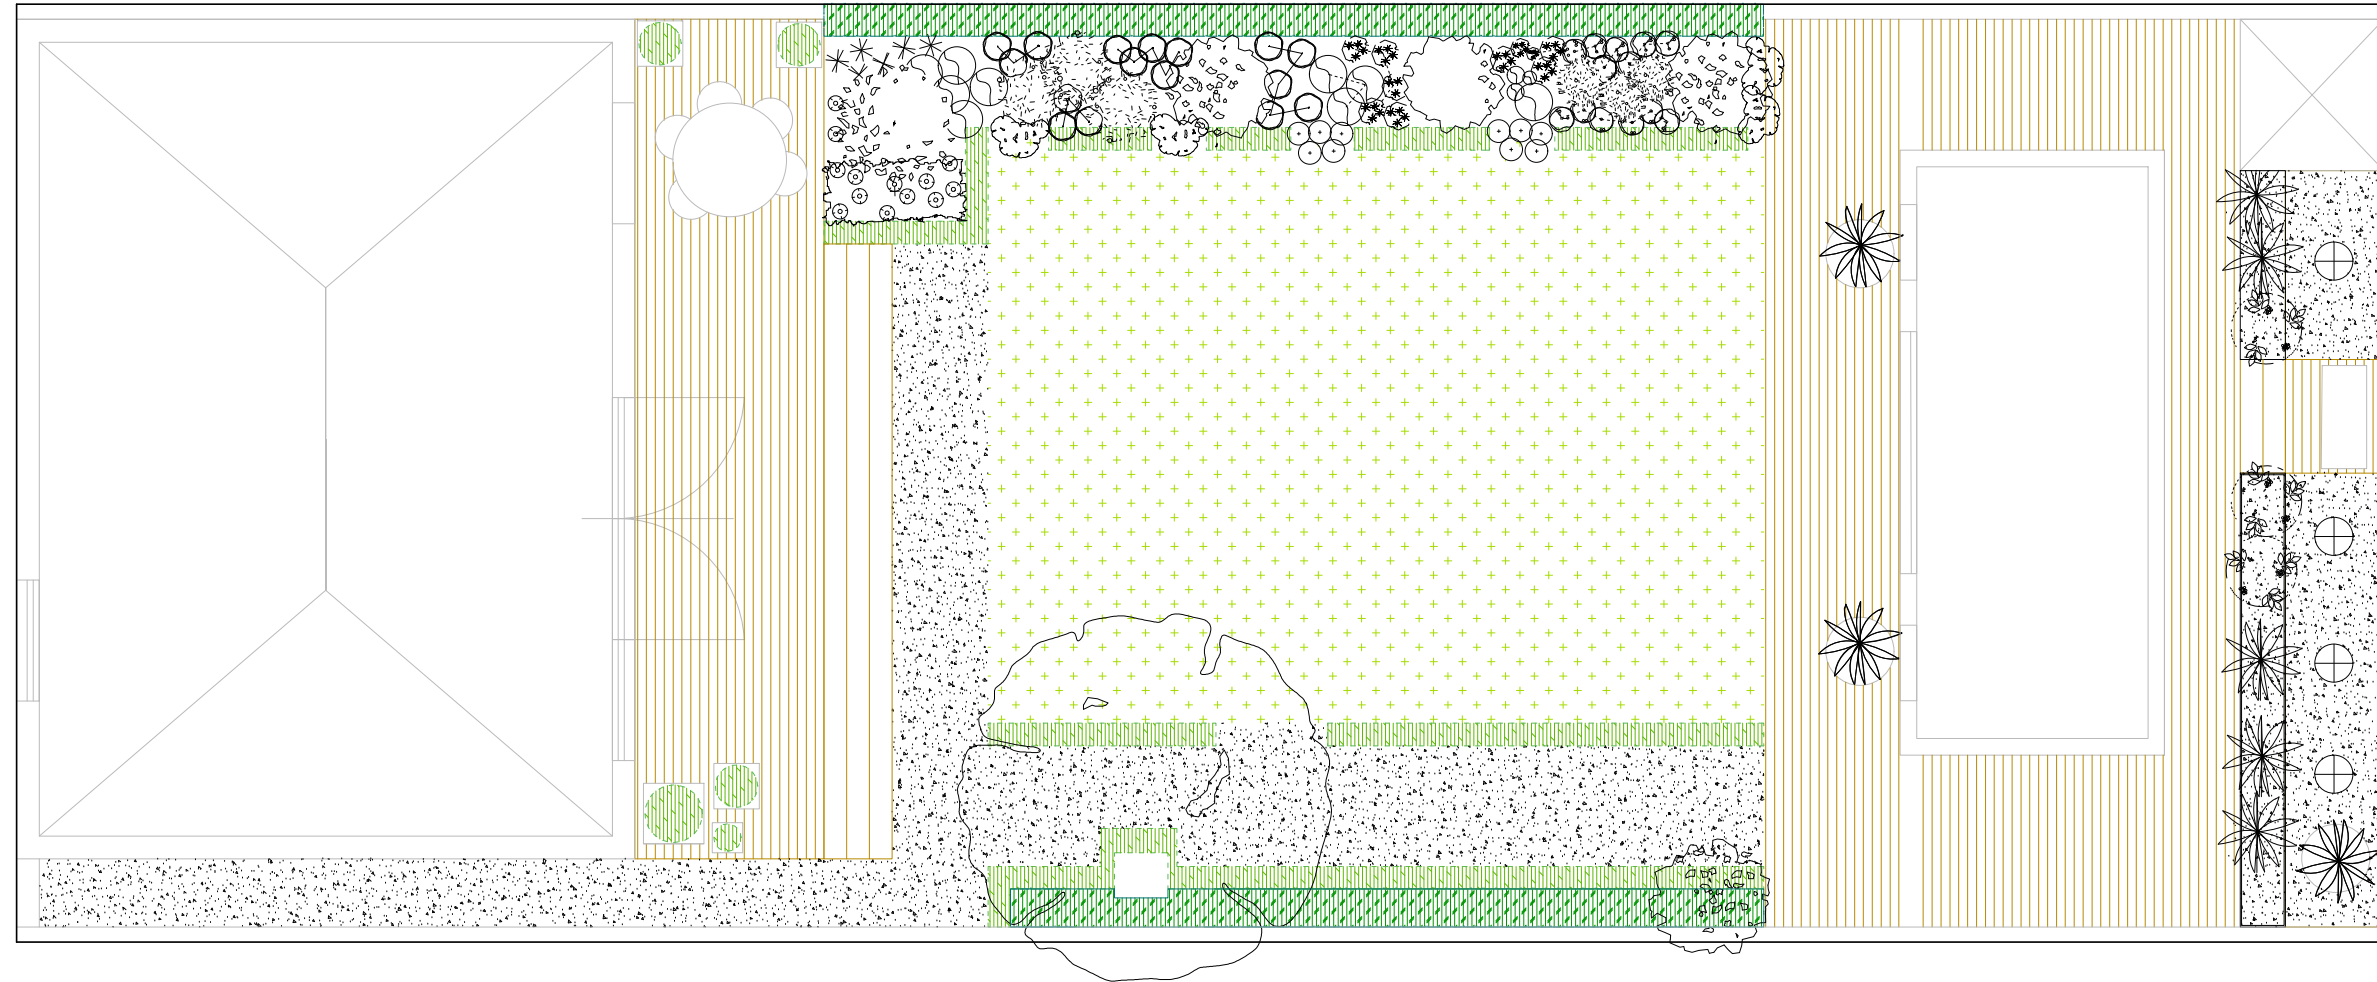

FRONT GARDEN PLAN

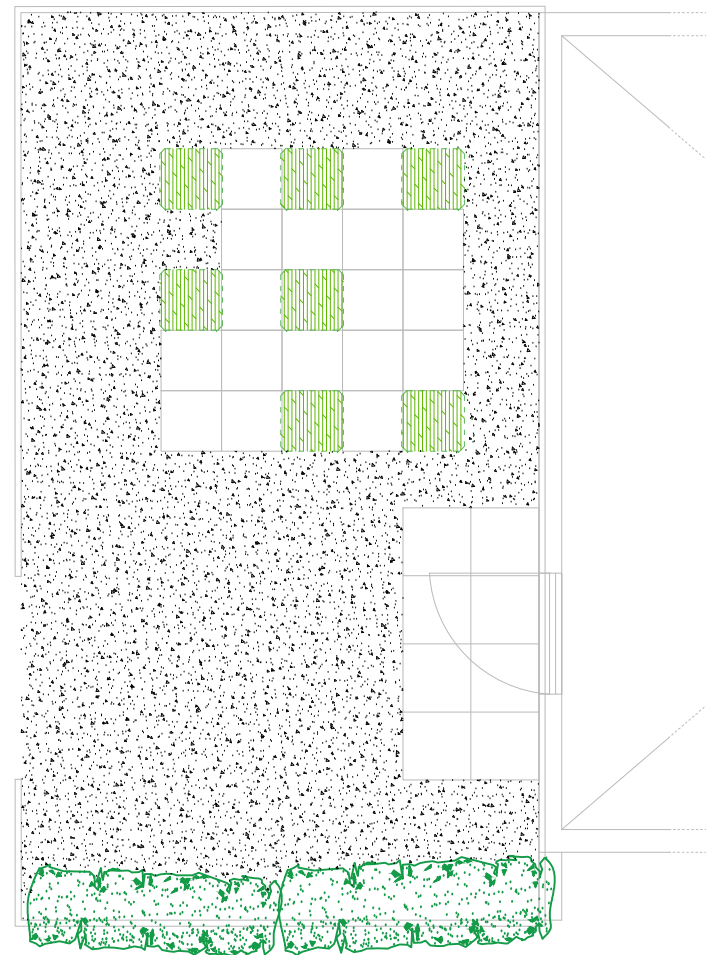

FLOWERING BED DETAIL

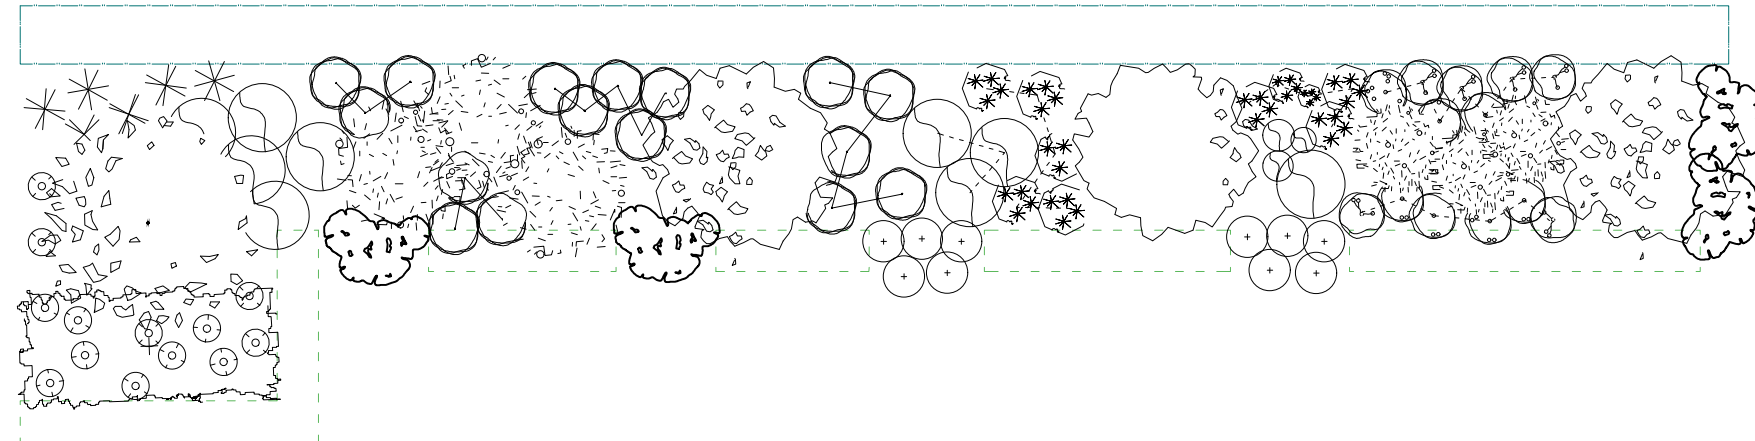

- Acer platanoides
- Acer palmatum
- Acer palmatum 'Atropurpureum'
- Magnolia stellata
- Acer palmatum dissectum
- Azalea kurume Hybrid 'Purple Splendor'
- Azalea Kurume Hybrid 'White Treasure'
- Phormium tenax 'Bronze Baby'
- Phormium tenax 'Variegatum'
- Nandina domestica
- Trachelospermum jasminoides | Clematis 'Jackmani'
- Ophiopogon planiscapus nigrescens
- Stachys bizantina
- Euphorbia x martinii 'Ascot Rainbow'
- Knautia macedonica 'Melton Pastels'
- Geranium 'Tanya Rendall'
- Acidanthera murielae
- Lilium regale
- Thalictrum aquilegifolium 'Black Stockings'
- Conifer | Thuja spp
- Taxus baccata
- Buxus sempervirens
- Gravel | Cotswold chippings
- Lawn

Season | Late spring

Project title
 Cavendish Stones & Claire Williams
 Interior Design Private Garden
 Barnes
 Drawing title
 Back Garden Plan
 Front Garden Plan
 Flowering Beds detail, out of scale

Scale 1:100 @ A3
 Status AS BUILT
 Date 10/10/2015

Drawing number
 1

